



09838946-092501

#3

EXPRESS MAIL NO.: EL897857759US

PATENT

IN THE UNITED STATES PATENT AND TRADEMARK OFFICE

Applicants : Nicola Zatelli et al.
Application No. : 09/838,946
Filed : April 19, 2001
For : METHOD FOR EVALUATING AN INTEGRATED ELECTRONIC
DEVICE

Art Unit : 2811
Docket No. : 854063.496D1
Date : September 25, 2001

Commissioner for Patents
Washington, DC 20231

REQUEST FOR DRAWING CHANGE

Commissioner for Patents:

Drawing changes, as indicated in red on the attached drawing of Figure 4, are hereby submitted for approval by the Examiner. The subject matter of Figure 4 is supported by the original specification, especially page 6, line 14 – page 7, line 15 and claims 1-10.

Respectfully submitted,
Nicola Zatelli et al.
Seed Intellectual Property Law Group PLLC

Robert Iannucci
Registration No. 33,514

RXI:kkh

Enclosures:

Postcard
Redlined Figure 4
Formal Drawing - Figure 4

701 Fifth Avenue, Suite 6300
Seattle, Washington 98104-7092
Phone: (206) 622-4900
Fax: (206) 682-6031

D:\NrPortbl\iManage\KRISTINEH\204844_1.DOC

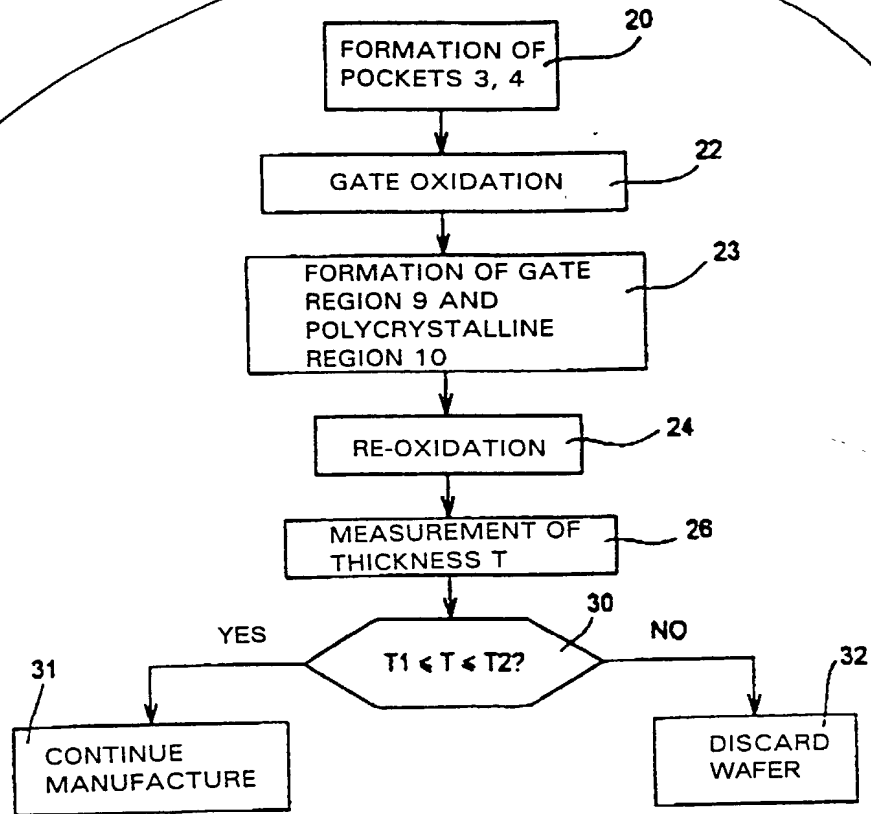


FIG. 4

Entire figure
is newly
provided